



BLOCK B - GROUND FLOOR PLAN

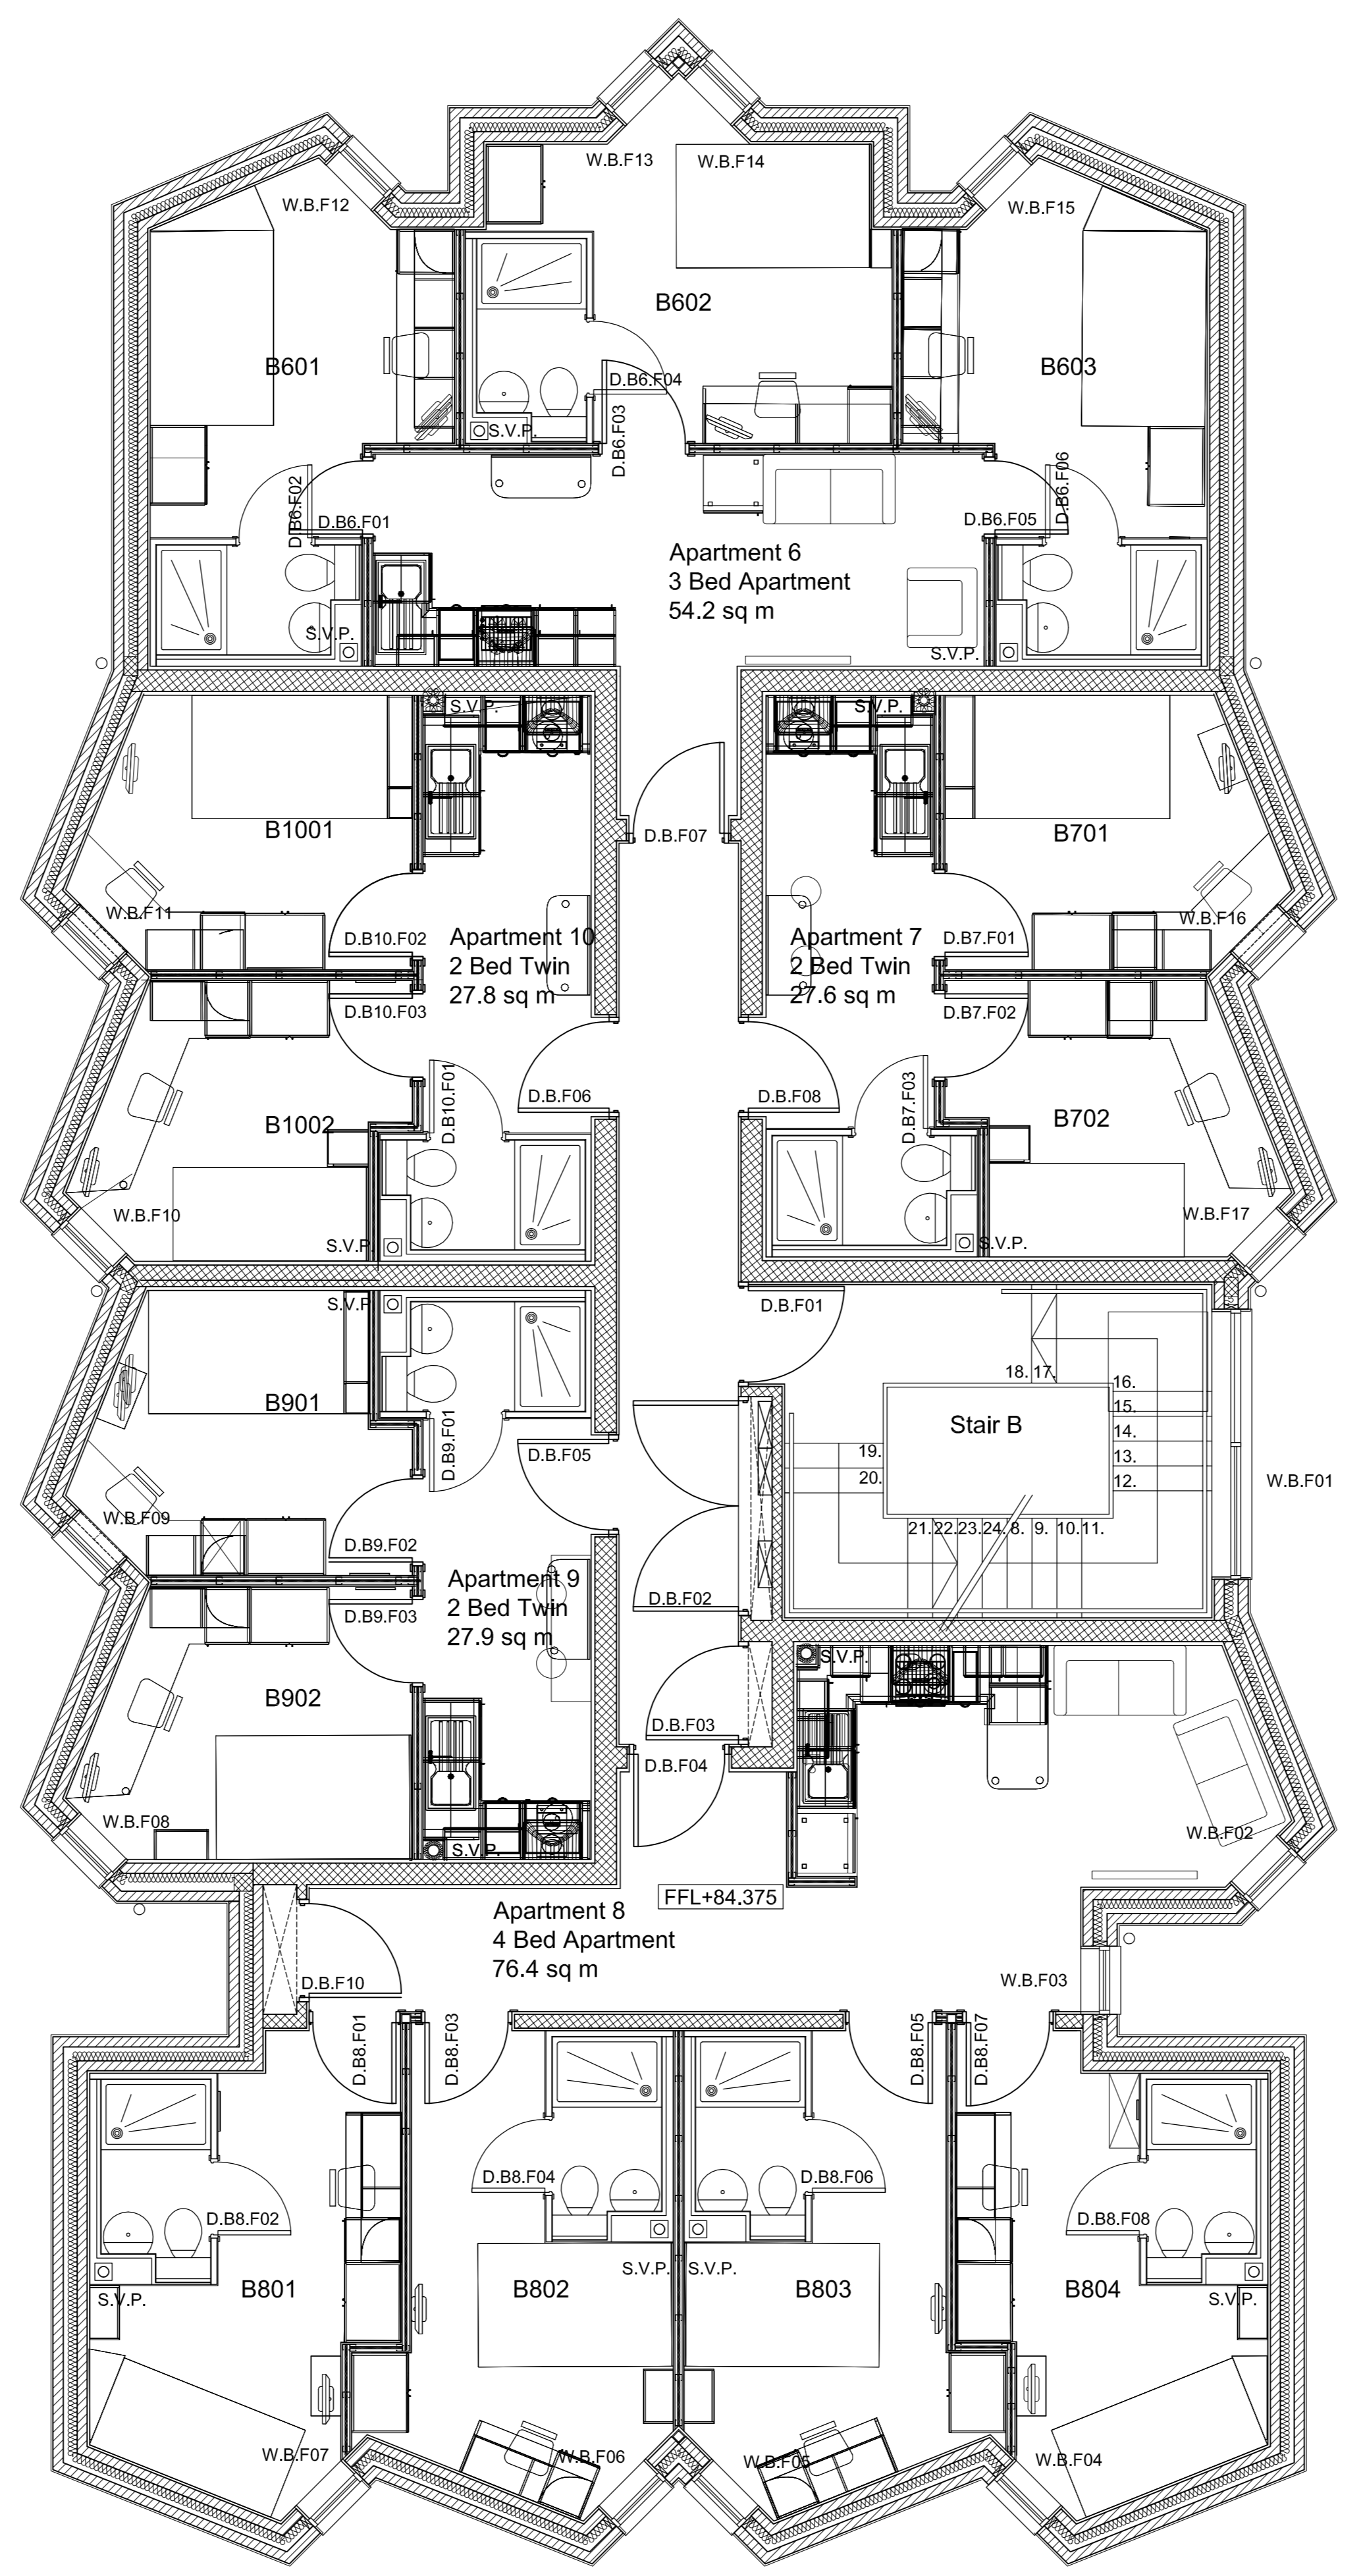

BLOCK B - FIRST FLOOR PLAN

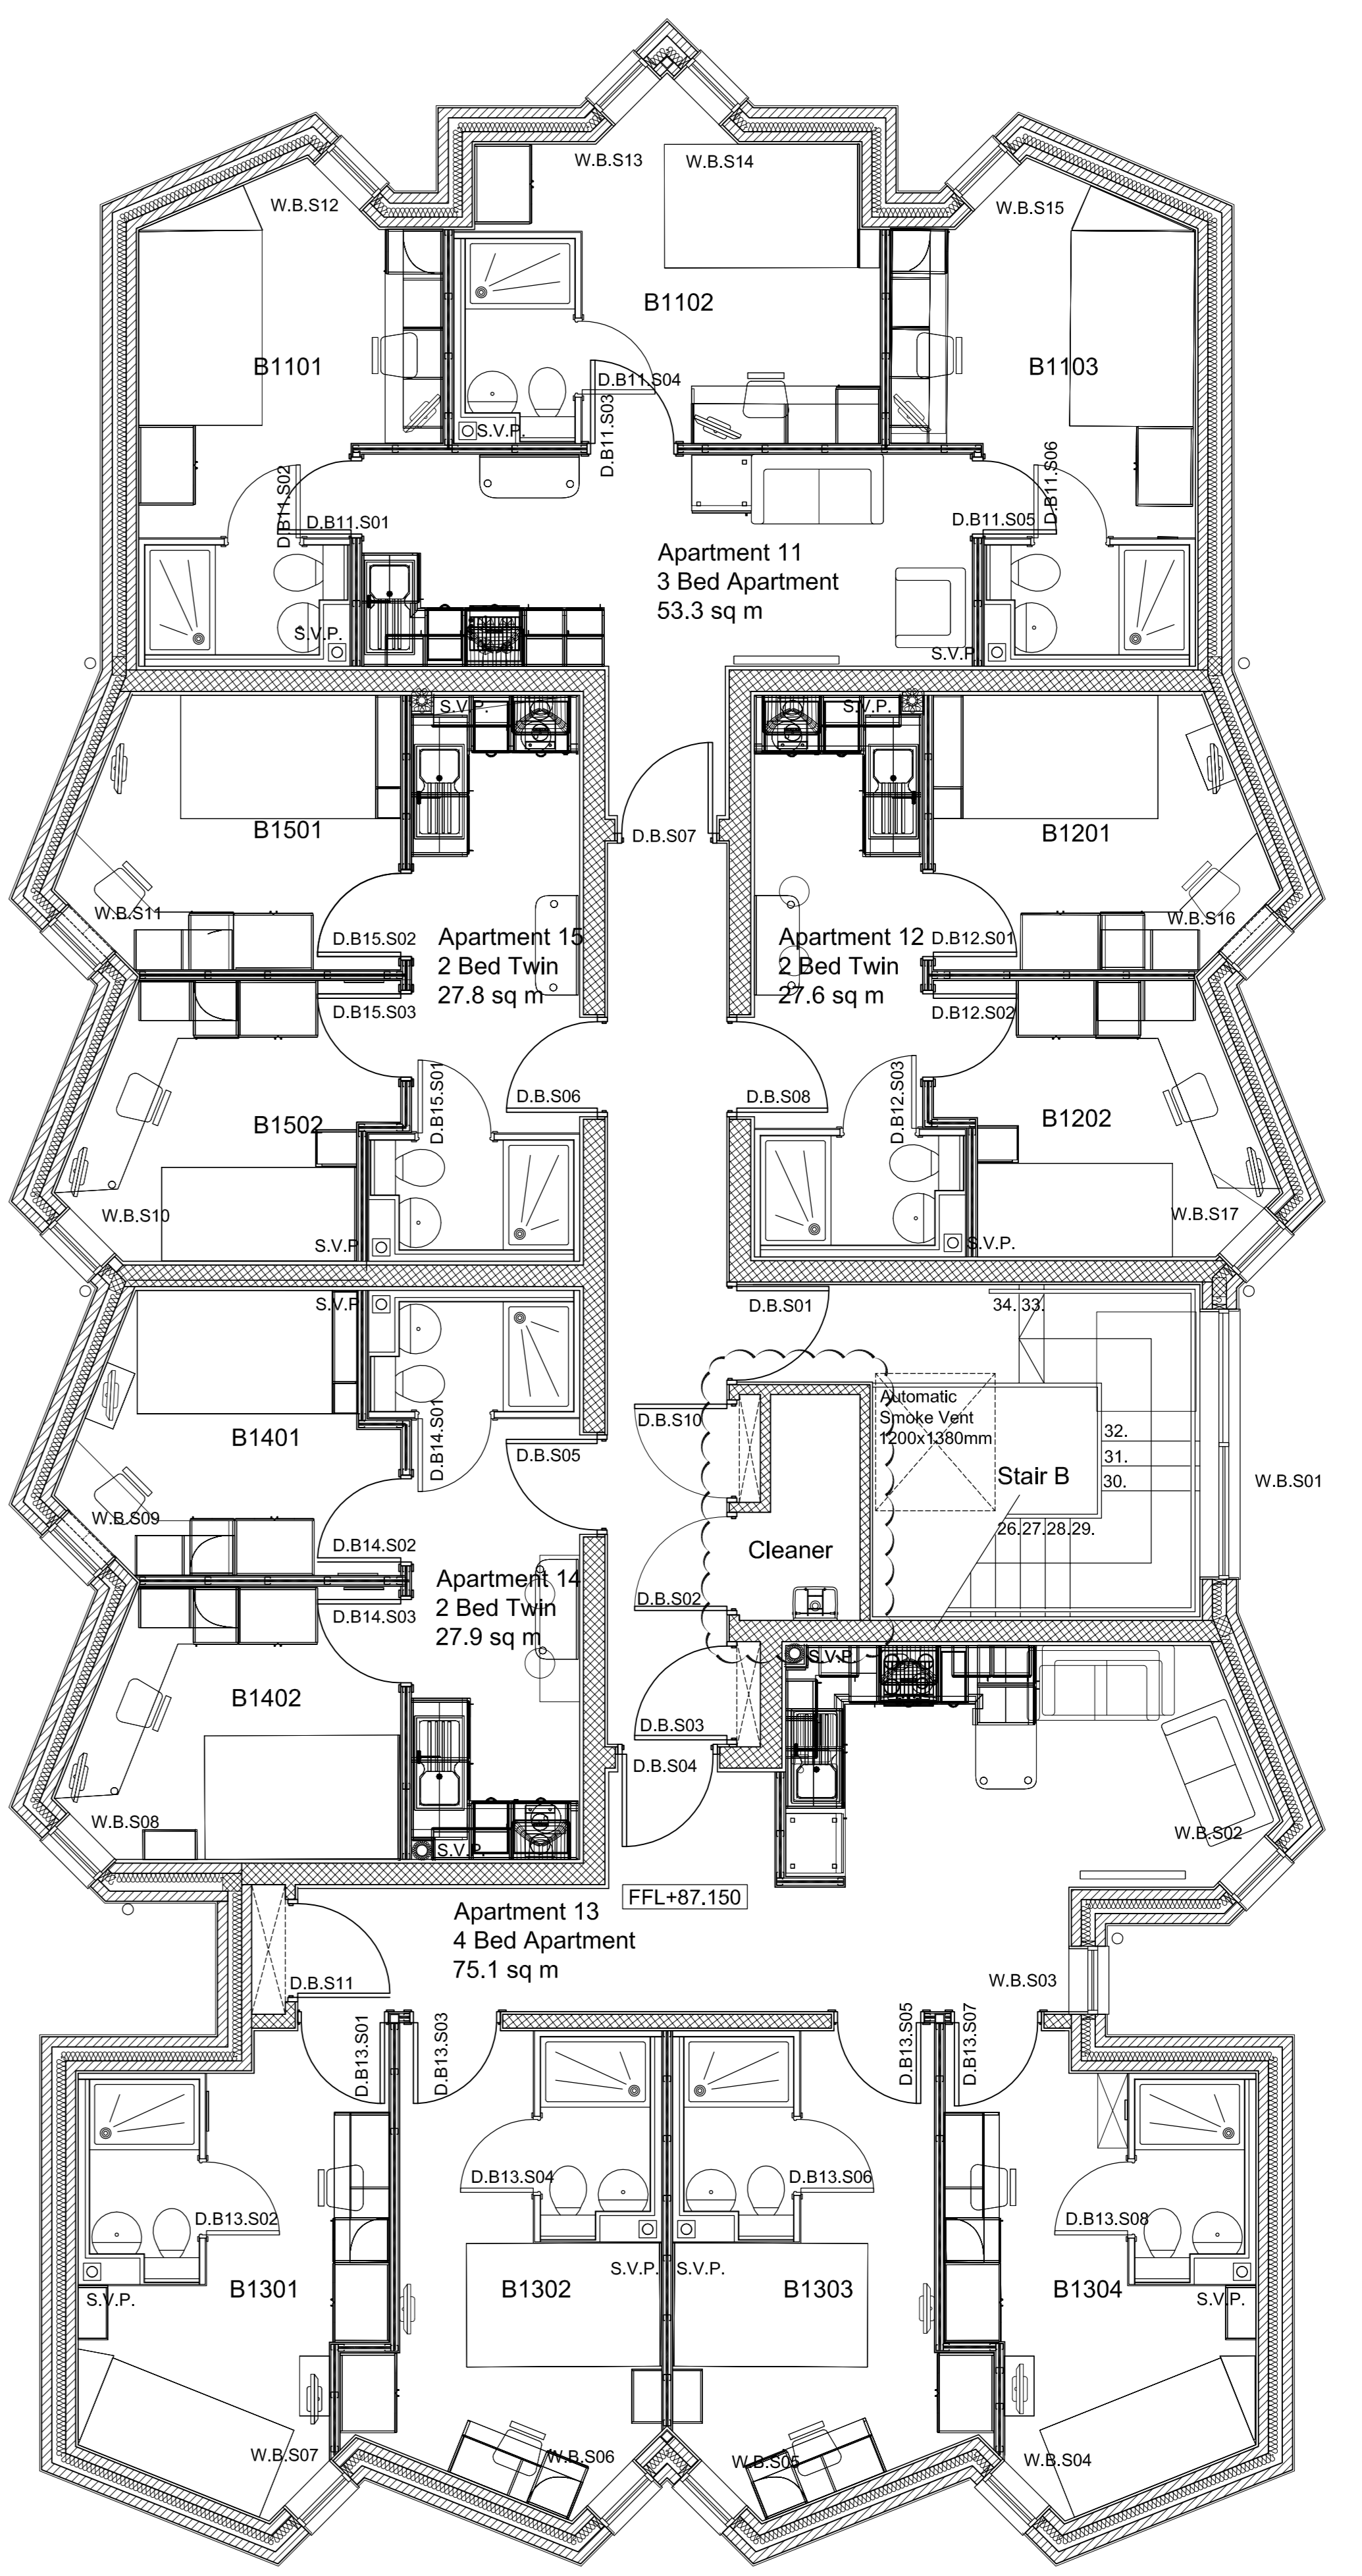

BLOCK B - SECOND FLOOR PLAN

RECORD DRAWING
 The information shown on this drawing reflects details originally incorporated or varied by Corstorphine & Wright and only such other conditions as have been advised to them by other parties. Corstorphine & Wright cannot guarantee that such details shown have been worked to.

E	02.07.13	Record drawing
D	15.01.13	Cleaners cup to second floor amended
C	04.12.12	Smoke vent size over stairwell amended
B	02.11.12	Risers updated.
A	20.09.12	Layouts updated.

RECORD DRAWING

Client
 GB BUILDING SOLUTIONS
 Project
 46 THE COMMON
 HATFIELD
 Drawing Title
 BLOCK B
 GROUND, FIRST AND SECOND FLOOR PLANS

Drawn	Checked	Paper Size	Scale	Date
JNS	PH	A0	1:50	14.09.12
Project No.	Drawing No.	Revision		
11699	2009	E		

CORSTORPHINE + WRIGHT